

### SPECIFICATIONS

CHASSIS: KME PREDATOR MPD FLAT ROOF  
 ENGINE: CATERPILLAR C-13 410 H.P. W/ JAKE  
 TRANSMISSION: ALLISON EVS-4000R  
 FRONT AXLE: MERITOR RS-23-133A-N 18,740#  
 REAR AXLE: MERITOR RS-23-186 24,000#  
 PUMP: HALE QMAX-150 RATED @1500 GPM  
 WATER TANK: 500 GALLON STAINLESS STEEL 10 GA.  
 W/25 GALLON INTEGRAL FOAM TANK

### COMPARTMENT SIZE

- (A): 62"H X 24 1/2"W X 23"/12"D @TOP - HINGE @ REAR  
 (B): 62"H X 50 3/4"W X 23"/12"D @TOP  
 (C): 29 1/2"H X 53"W X 12"D  
 (D): 30"H X 48"W X 24"D ISOLATED  
 (E): 38 1/2"H X 22"W X 15"D  
 (F): 30"H X 50 3/4"W X 23"D  
 (G): 30"H X 24 1/2"W X 23"D - HINGE @ REAR

### DOOR OPENING

- (A): 61"H X 21"W  
 (B): 61"H X 46"W  
 (C): 27 1/2"H X 49"W  
 (D): 29"H X 40"W  
 (E): 36"H X 19 1/2"W  
 (F): 31"H X 46"W  
 (G): 31"H X 21"W

### DISCHARGES

- (2) 2 1/2" LEFT SIDE  
 (1) 2 1/2" RIGHT SIDE  
 (1) 3" DECK GUN W/ADDITIONAL 2 1/2" FOAM VALVE  
 (1) 2 1/2" RIGHT SIDE/REAR  
 (1) 2 1/2" @ EACH SIDE TRANSVERSE BED NO CAP  
 (2) 3" RIGHT SIDE W/ 4" NST ADAPTER & CAP  
 (2) 1-1/2" TO BOOSTER REELS

### PLEASE REVIEW AND RETURN A SIGNED COPY.

NAME: \_\_\_\_\_  
 TITLE: \_\_\_\_\_  
 DATE: \_\_\_\_\_

### CUSTOMER PAINT CODES:

SINGLE STAGE PPG PAINT SYSTEM TO MATCH LOWER CAB AND BODY: **RED-#674**  
 CAB TWO TONE (IF APPLICABLE): **N/A**  
 COLOR INTERIOR/DOOR/UNDERBODY/ FLOOR/ PULPING TO BE SUPPLIED  
 THIS DRAWING IS A GENERAL CONFIGURATION AND MAY NOT NECESSARILY REFLECT ALL CONTRACTUAL REQUIREMENTS

| SYM | DATE     | REVISION DESCRIPTION          | APP'D |
|-----|----------|-------------------------------|-------|
| D   | 02/13/06 | REVISED AS-BUILT DRAWING      | MAK   |
| C   | 10/05/05 | REVISED PER REVISED LETTER    | MAK   |
| B   | 07/15/05 | REVISED PER PRE-BUILD MEETING | MAK   |
| A   | 03/22/05 | PROPOSAL FOR FD410A-04-05     | MAK   |

SALES ENGINEER: **MARK KOPUNEK**

**KOVATCH MOBILE EQUIPMENT**


ONE INDUSTRIAL COMPLEX  
 REDBURNING, PA 18240

TOLERANCE UNLESS OTHERWISE SPECIFIED  
 DECIMALS FRACTIONS: ±1/8"  
 ONE PLACE ±.060 THREE PLACE: ±.010  
 TWO PLACE ±.030 ANGLES: ±2' AND SHARP EDGES

SCALE DRAWN BY **J.J.M.**  
 2-23-05 NONE APPROVED BY **MAK**

**CAB**

TYPE "A" KME CUSTOM PUMPER  
 LOS ANGELES COUNTY  
 GSO # 6253

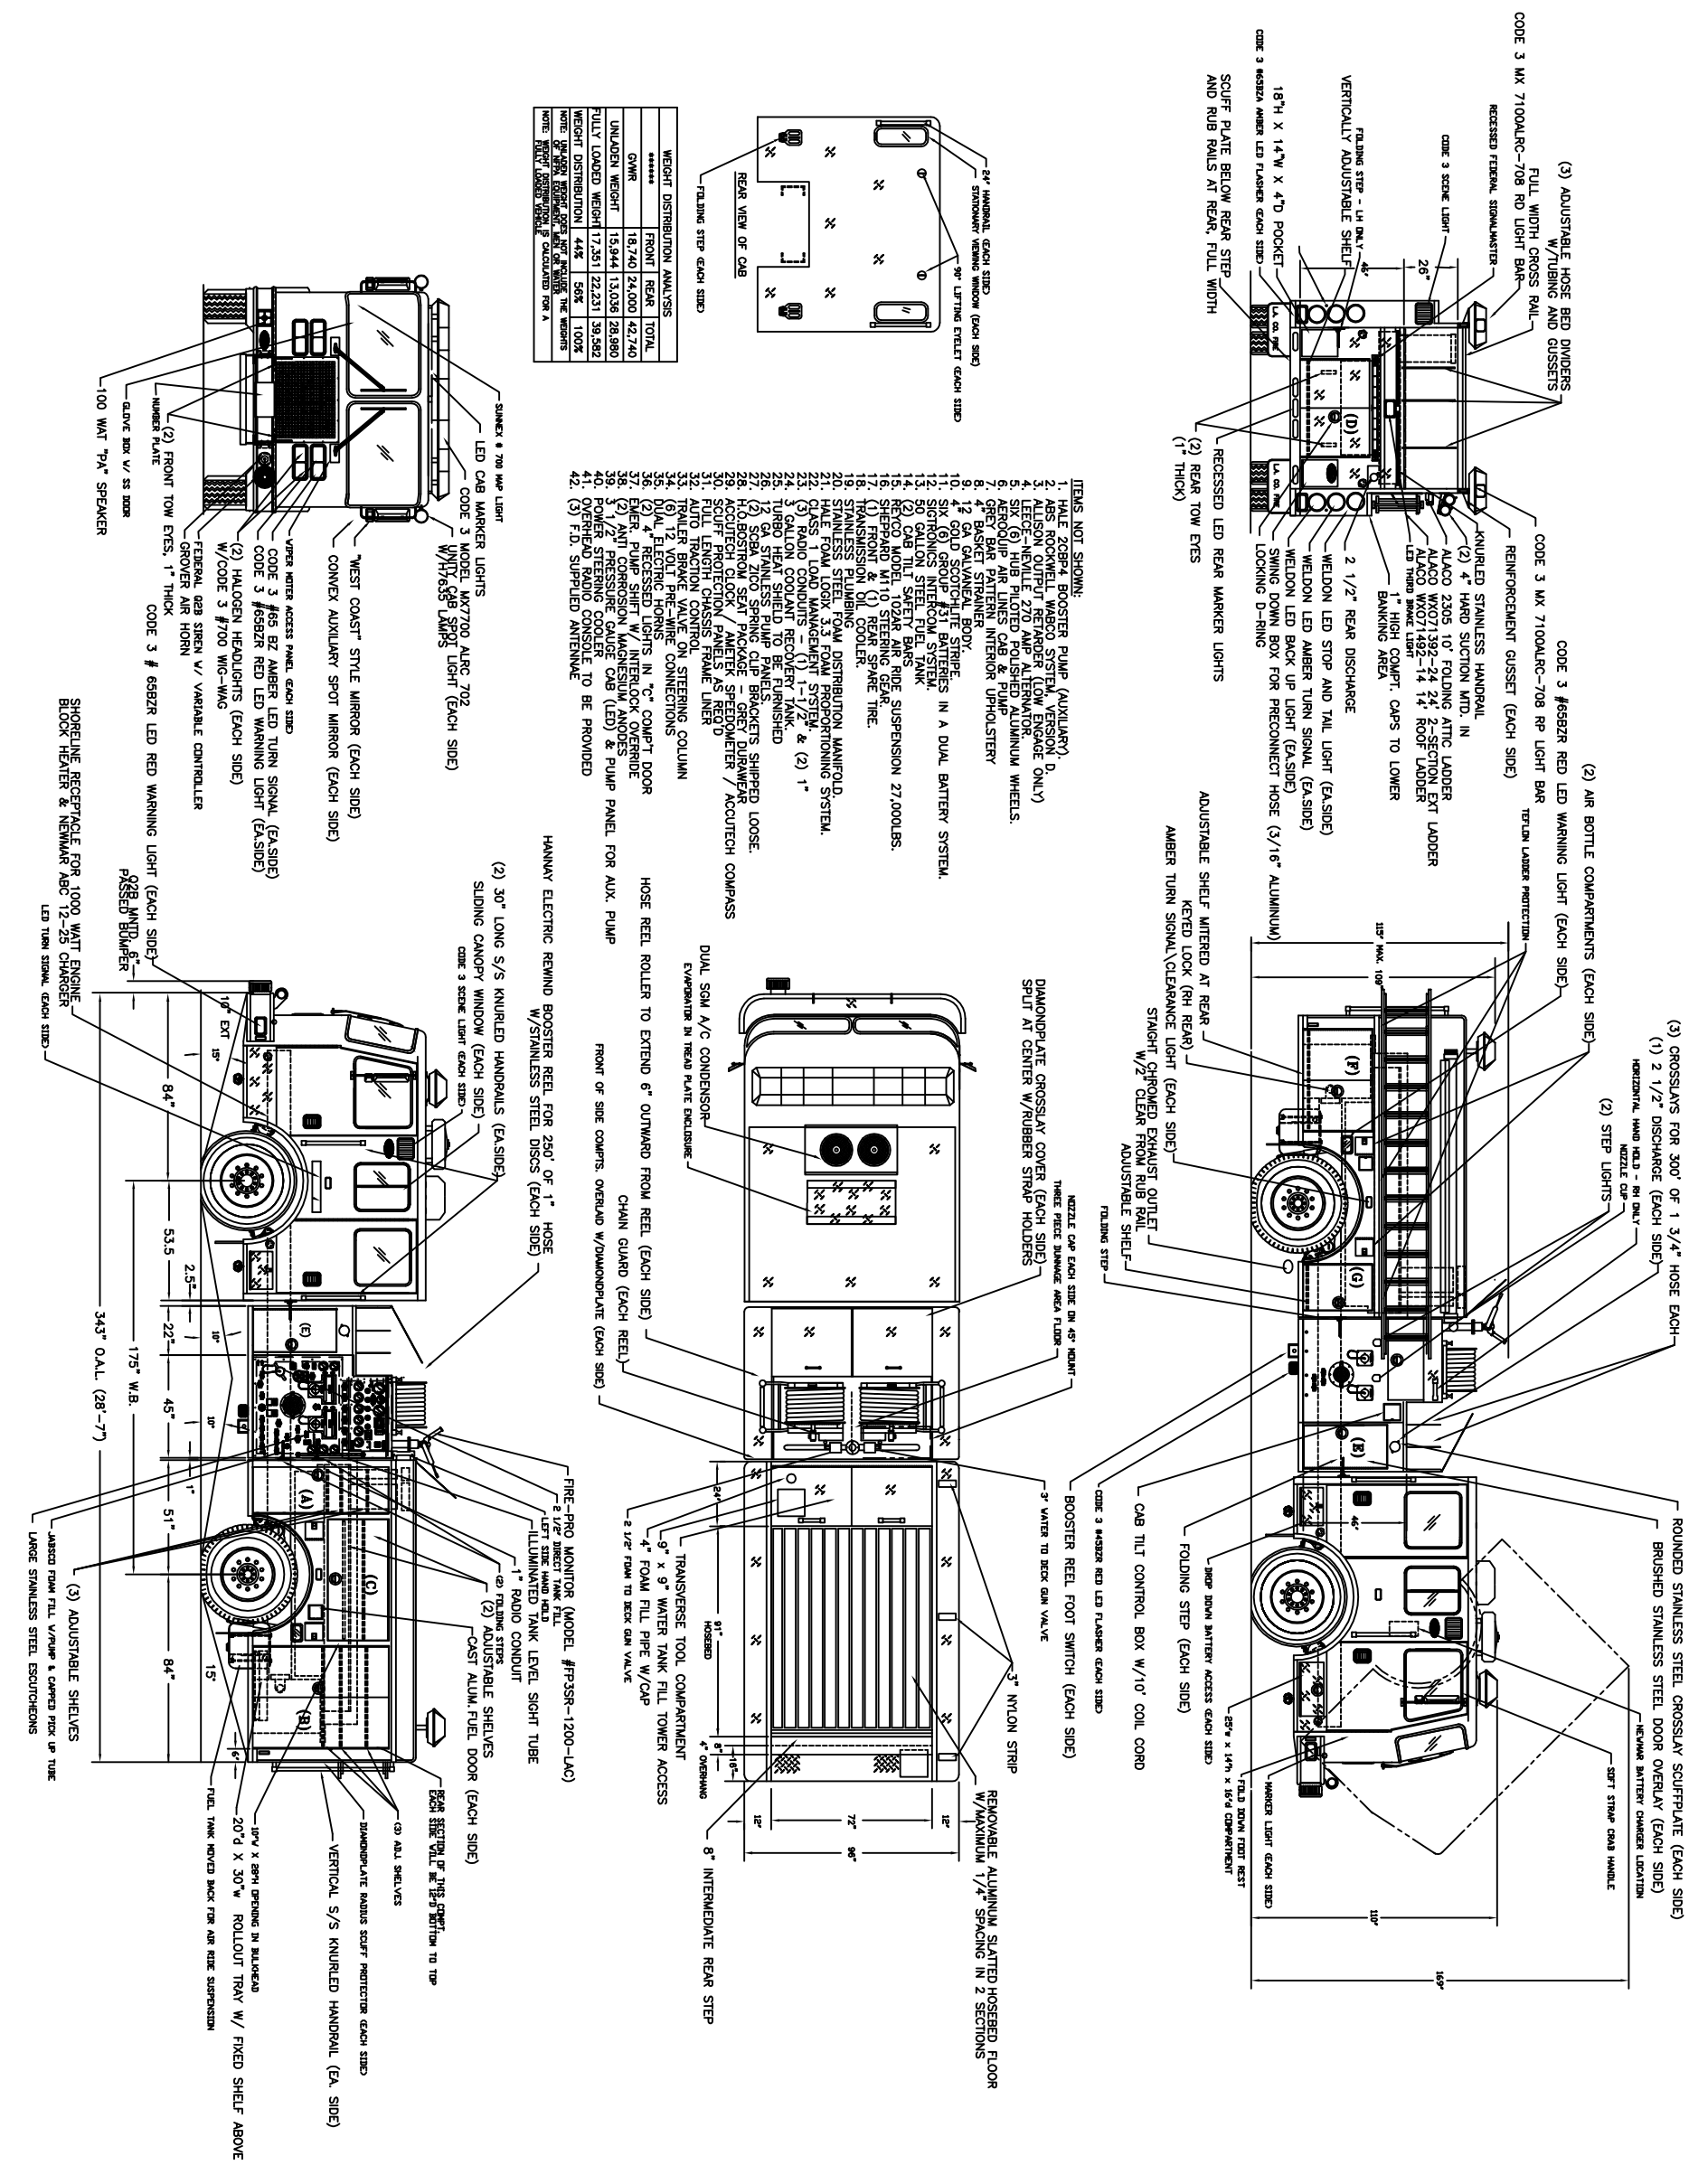

DO NOT CHANGE MANUALLY